



Date: September 8, 2026

Project: State of North Dakota
ND State Capitol 14th Floor Renovation
Bismarck, North Dakota

J2 Studio #: J22534

RE: Addendum #1

From: J2 Studio Architecture + Design
919 South 7th Street, Suite 400
Bismarck, ND 58504
Phone: (701) 255-1622
Fax: (701) 223-8927

To: All Planholders on record

No. of Pages: 12 (4 - 8½ x 11 Addendum Body, 3 – 8 ½ x 11 Specifications, 1 – 11 x 17 Drawing, 2 – 24x36 Drawings, 1 - 8 ½ x 11 Planholders List, 1 – 8 ½ x 11 Pre-Bid Sign-In Sheet)

General

1. **The bid date and time shall be Tuesday, September 22nd at 1:30pm. Multiple Prime Bids shall be delivered to the office of the Owner on the 4th floor of the Capitol Tower by 1:00 pm or brought directly to the bid opening in the Red River Room at 1:30pm.**
 - a. Bids will be opened publicly.
2. Bids shall be submitted in a double envelope with the Contractor's license and bid security submitted in a separate small envelope attached to a larger envelope containing the bid forms.
 - a. Bids shall be submitted per the specifications.
3. A pre-bid conference was held on Tuesday, September 1st, 2026. The following were in attendance:
 - a. James Devine & Carrie Meyer – J2 Studio
 - b. Tom Job – State of North Dakota Office of Facility Management
 - c. Wes Gullicks – Apex Engineering Group
 - d. Chris Wentz – CWStructural
 - e. Matt Kimball – Northwest Contracting
 - f. James Rudd – Edling Electric

- g. Trae Garvie – Oztech Electric
 - h. Farrell Fetzer – Fetzer Electric
4. In addition to an overview of the project, the following items were discussed. Applicable items should be included in the Contract Documents per this addendum. This is not a complete list of the work required. Contractors shall refer to the Contract Documents for the complete scope of work. All comments shall be reviewed by bidders.
- a. The project consists of the installation of exterior wayfinding signage throughout the Capitol grounds.
 - b. Commencement of work is anticipated to be October 5th, 2026 with the installation of the foundations this fall. Work shall continue through the winter, or recommence in the spring as weather permits. Substantial Completion shall be May 13, 2027 and Final Completion of May 27, 2027. Shop drawing submittals shall begin immediately after the Notice of Award/Notice to Proceed.
 - c. There are 5 alternate bids on the project:
 - i. Alt. Bid G1: limestone base in lieu of precast at pedestal sign types 1-3.
 - ii. Alt. Bid G2: pedestal sign type 1 install at pedestal sign 3 locations.
 - iii. Alt. Bid G3 & E3: installation of monument sign 1.
 - iv. Alt. Bid G4 & E4: installation of monument sign 2.
 - v. Alt. Bid G5: installation of building signage at entry.
 - d. The entire aluminum sign cabinet shall be by the sign supplier. The lighting within the signs shall be provided by the electrical contractor. The electrical contractor and sign supplier shall coordinate installation of the lighting.
 - e. The contractor shall notify facilities for underground locates at the same time that one-call is contacted.
 - f. Contractors shall include an allowance of \$2,500 for any costs associated with relocation of irrigation systems.
5. This is a multiple prime project.
- a. Each contractor is responsible for their own bid bond, as well as performance and payment bonds.
 - b. The General Contractor is responsible for maintaining the overall project schedule with input the mechanical and electrical contractors. Each prime contractor is responsible for coordinating work within their trades.
 - c. If the sign supplier has a Class A contractor's license, they can bid the entirety of the sign work, including the foundation and precast/limestone/granite. Otherwise, they may bid to a general contractor.
6. Badge access will be required for any contractor needing access to the building.
- a. Badges are \$10, and cost shall be by the Contractor.
 - i. Provide a separate email for each person needing a badge, with photo (not driver's license), name, address and company. The list shall be emailed to Tom Job: tjob@nd.gov.
 - ii. Highway Patrol will bill the company directly.
 - b. If an employee has their badge from a previous project, it can be reactivated and the \$10 is not required.
 - i. Email Tom Job with badge number on the back to reactivate.
7. Electrical contractor will be required to pull a permit for this project. No other permit is required.
8. Davis-Bacon wages are not required on the project.
9. The contractors are responsible for sales tax on the project.
10. General clarification: the letters on the monument signs are intended to be lit out the front, and similar to the Heritage Center signage. The dimensional letters noted in the specifications are for the wall mounted lettering for Alternate Bid 5.

Specifications

00 4100 Bid Form

1. Replace bid form in its entirety with attached document, which now includes unit pricing.

01 2200 Unit Prices

1. Add section in its entirety.

Drawings

Cover

1. Index; revise electrical number to E106 Area 7 Electrical Plan
 - a. General clarification; sheet number is correct on electrical drawings, and was mislabeled on index.
2. Electrical Engineer consultant for Apex Engineering is Wes Gullicks, PE. All contact information is the same.
3. Owner's contact phone number for Tom Job at the State of North Dakota is 701-328-4783.

A102 Site Plan – Area A

4. Drawings 1/A102; revise as follows and per attachment A1.
 - a. Add additional Pedestal Sign Type 1 at the location indicated on attachment A1; located northeast of the J-Wing.

Electrical Drawings

1. Refer to attached electrical addendum.

Approved Equals

Specification Section	Product/Paragraph	Approved Equal
None		

End of Addendum #1

State of North Dakota
Capitol Visitor Enhancements – Exterior Signage
Bismarck, North Dakota

ADDENDUM E1
J2 Studio Architecture + Design
Bismarck, North Dakota

September 8, 2026

J22534

Please add the following Addendum to the plans and specifications that you have on file. The contractor shall acknowledge on the Bid Form receipt of this Addendum.

SPECIFICATIONS

1. NA

DRAWINGS

Sheet E102: Area 1 & 2 Electrical Plan:

1. Detail 1: Area 1 Electrical Plan – Northwest Pedestrian Path:
 - a. Refer to revised drawing for Alternate Bid #E3 notation for all work associated with the ND State Lab monument sign. No work associated with this sign location is to be included in Base Bid.
2. Detail 2: Area 2 Electrical Plan – Judicial Wing Entrance:
 - a. Refer to revised drawing for an additional pedestal sign location.

Sheet E104: Area 4 & 5 Electrical Plan:

1. Detail 2: Area 5 Electrical Plan – Governor's Residence:
 - a. Refer to revised drawing for Alternate Bid #E4 notation for all work associated with the ND Governor's Residence monument sign. No work associated with this sign location is to be included in Base Bid.

PRIOR APPROVALS:

The following materials and/or suppliers, in addition to those specified, have been approved as acceptable for use on the project contingent on compliance with the specifications and performance criteria as specified. All items are subject to the submittal and final approval of shop drawings and product data by the successful contractors and/or suppliers.

1. None

END OF ADDENDUM E1

**SECTION 00 4100
BID FORM**

THE PROJECT AND THE PARTIES

1.01 TO:

- A. State of North Dakota (Owner)
600 East Boulevard Avenue
Bismarck, ND 58505

1.02 FOR:

- A. Project: State of North Dakota Visitor Enhancements - Exterior Signage
B. Architect's Project Number: J22534
600 East Boulevard Avenue, Bismarck, ND 58505
Bismarck, North Dakota 58505

1.03 DATE: _____ (BIDDER TO ENTER DATE)

1.04 SUBMITTED BY: (BIDDER TO ENTER NAME AND ADDRESS)

- A. Bidder's Full Name _____
1. Address _____
2. City, State, Zip _____
B. Bid Type: (General, Mechanical, Electrical): _____

1.05 OFFER

- A. Having examined the Place of The Work and all matters referred to in the Instructions to Bidders and the Bid Documents prepared by J2 Studio Architecture + Design, PC for the above mentioned project, we, the undersigned, hereby offer to enter into a Contract to perform the Work for the Sum of:
B. _____ dollars
(\$ _____), in lawful money of the United States of America.
C. We have included the required security deposit as required by the Instruction to Bidders.
D. All applicable federal taxes are included and State of North Dakota taxes are included in the Bid Sum.
E. We will comply and provide required insurance per State's Addendum to AIA Documents A101-2017 and A201-2017, Article 11.

1.06 ACCEPTANCE

- A. This offer shall be open to acceptance and is irrevocable for sixty days from the bid closing date.
B. If this bid is accepted by Owner within the time period stated above, we will:
1. Execute the Agreement within seven days of receipt of Notice of Award.
2. Commence work within seven days after written Notice to Proceed of this bid.
C. If this bid is accepted within the time stated, and we fail to commence the Work or we fail to provide the required Bond(s), the security deposit shall be forfeited as damages to Owner by reason of our failure, limited in amount to the lesser of the face value of the security deposit or the difference between this bid and the bid upon which a Contract is signed.
D. In the event our bid is not accepted within the time stated above, the required security deposit shall be returned to the undersigned, in accordance with the provisions of the Instructions to Bidders; unless a mutually satisfactory arrangement is made for its retention and validity for an extended period of time.

1.07 CONTRACT TIME

- A. If this Bid is accepted, we will:
- B. Complete the Work by the _____ day of _____, _____. (Bidder to enter day, month, and year.)

1.08 UNIT PRICES

- A. The following are Unit Prices for specific portions of the Work as listed. The following is the list of Unit Prices:
- B. ITEM DESCRIPTION - UNIT QUANTITY - UNIT PRICE - ITEM VALUE
- C. Unit Price #1 - Additional Pedestal Sign Type #1 - Price per Item - \$ _____

1.09 CHANGES TO THE WORK

- A. Refer to State's Addendum to AIA Documents A101-2017 and A201-2017 paragraph 7.2.3 for limits on percentages.

1.10 ADDENDA

- A. The following Addenda have been received. The modifications to the Bid Documents noted below have been considered and all costs are included in the Bid Sum.
 - 1. Addendum # _____ Dated _____.
 - 2. Addendum # _____ Dated _____.
 - 3. Addendum # _____ Dated _____.
 - 4. Addendum # _____ Dated _____.
 - 5. Addendum # _____ Dated _____.

1.11 BID FORM SUPPLEMENTS

- A. The following Supplements are attached to this Bid Form and are considered an integral part of this Bid Form:
 - 1. Document 00 4323 - Alternates Form: Include the cost variations to the Bid Sum applicable to the Work as described in Section 01 2300.
- B. We agree to submit the following Supplements to Bid Forms within 48 hours after the Notice to Proceed:
 - 1. Document 00 4373 - Proposed Schedule of Values Form identifies the Bid Price/Sum segmented into portions as requested.

1.12 BID FORM SIGNATURE(S)

- A. The Corporate Seal of
- B. _____
- C. (Bidder - print the full name of your firm)
- D. was hereunto affixed in the presence of:
- E. _____
- F. (Authorized signing officer, Title)
- G. (Seal)
- H. _____
- I. (Authorized signing officer, Title)

1.13 IF THE BID IS A JOINT VENTURE OR PARTNERSHIP, ADD ADDITIONAL FORMS OF EXECUTION FOR EACH MEMBER OF THE JOINT VENTURE IN THE APPROPRIATE FORM OR FORMS AS ABOVE.

END OF SECTION

**SECTION 01 2200
UNIT PRICES**

PART 1 GENERAL

1.01 SECTION INCLUDES

- A. List of unit prices, for use in preparing Bids.
- B. Measurement and payment criteria applicable to Work performed under a unit price payment method.

1.02 COSTS INCLUDED

- A. Unit Prices included on the Bid Form shall include full compensation for all required labor, products, tools, equipment, plant, transportation, services and incidentals; erection, application or installation of an item of the Work; overhead and profit.

1.03 UNIT QUANTITIES SPECIFIED

- A. Quantities indicated in the Bid Form are for bidding and contract purposes only. Quantities and measurements of actual Work will determine the payment amount.

1.04 MEASUREMENT OF QUANTITIES

- A. Take all measurements and compute quantities. Measurements and quantities will be verified by Architect.
- B. Assist by providing necessary equipment, workers, and survey personnel as required.

1.05 PAYMENT

- A. Payment for Work governed by unit prices will be made on the basis of the actual measurements and quantities of Work that is incorporated in or made necessary by the Work and accepted by the Architect, multiplied by the unit price.


1.06 SCHEDULE OF UNIT PRICES

- A. Item: No. 1; Install additional signage:
 - 1. Base Bid: Include a price to install signage at the locations indicated on the drawings and in the specifications.
 - 2. Unit Price No. 1: Provide a price per item to provide and install additional Pedestal Sign Type 1.
 - a. Note: Electrical work required for this unit price shall be addressed by Change Order.

PART 2 PRODUCTS - NOT USED

PART 3 EXECUTION - NOT USED

END OF SECTION

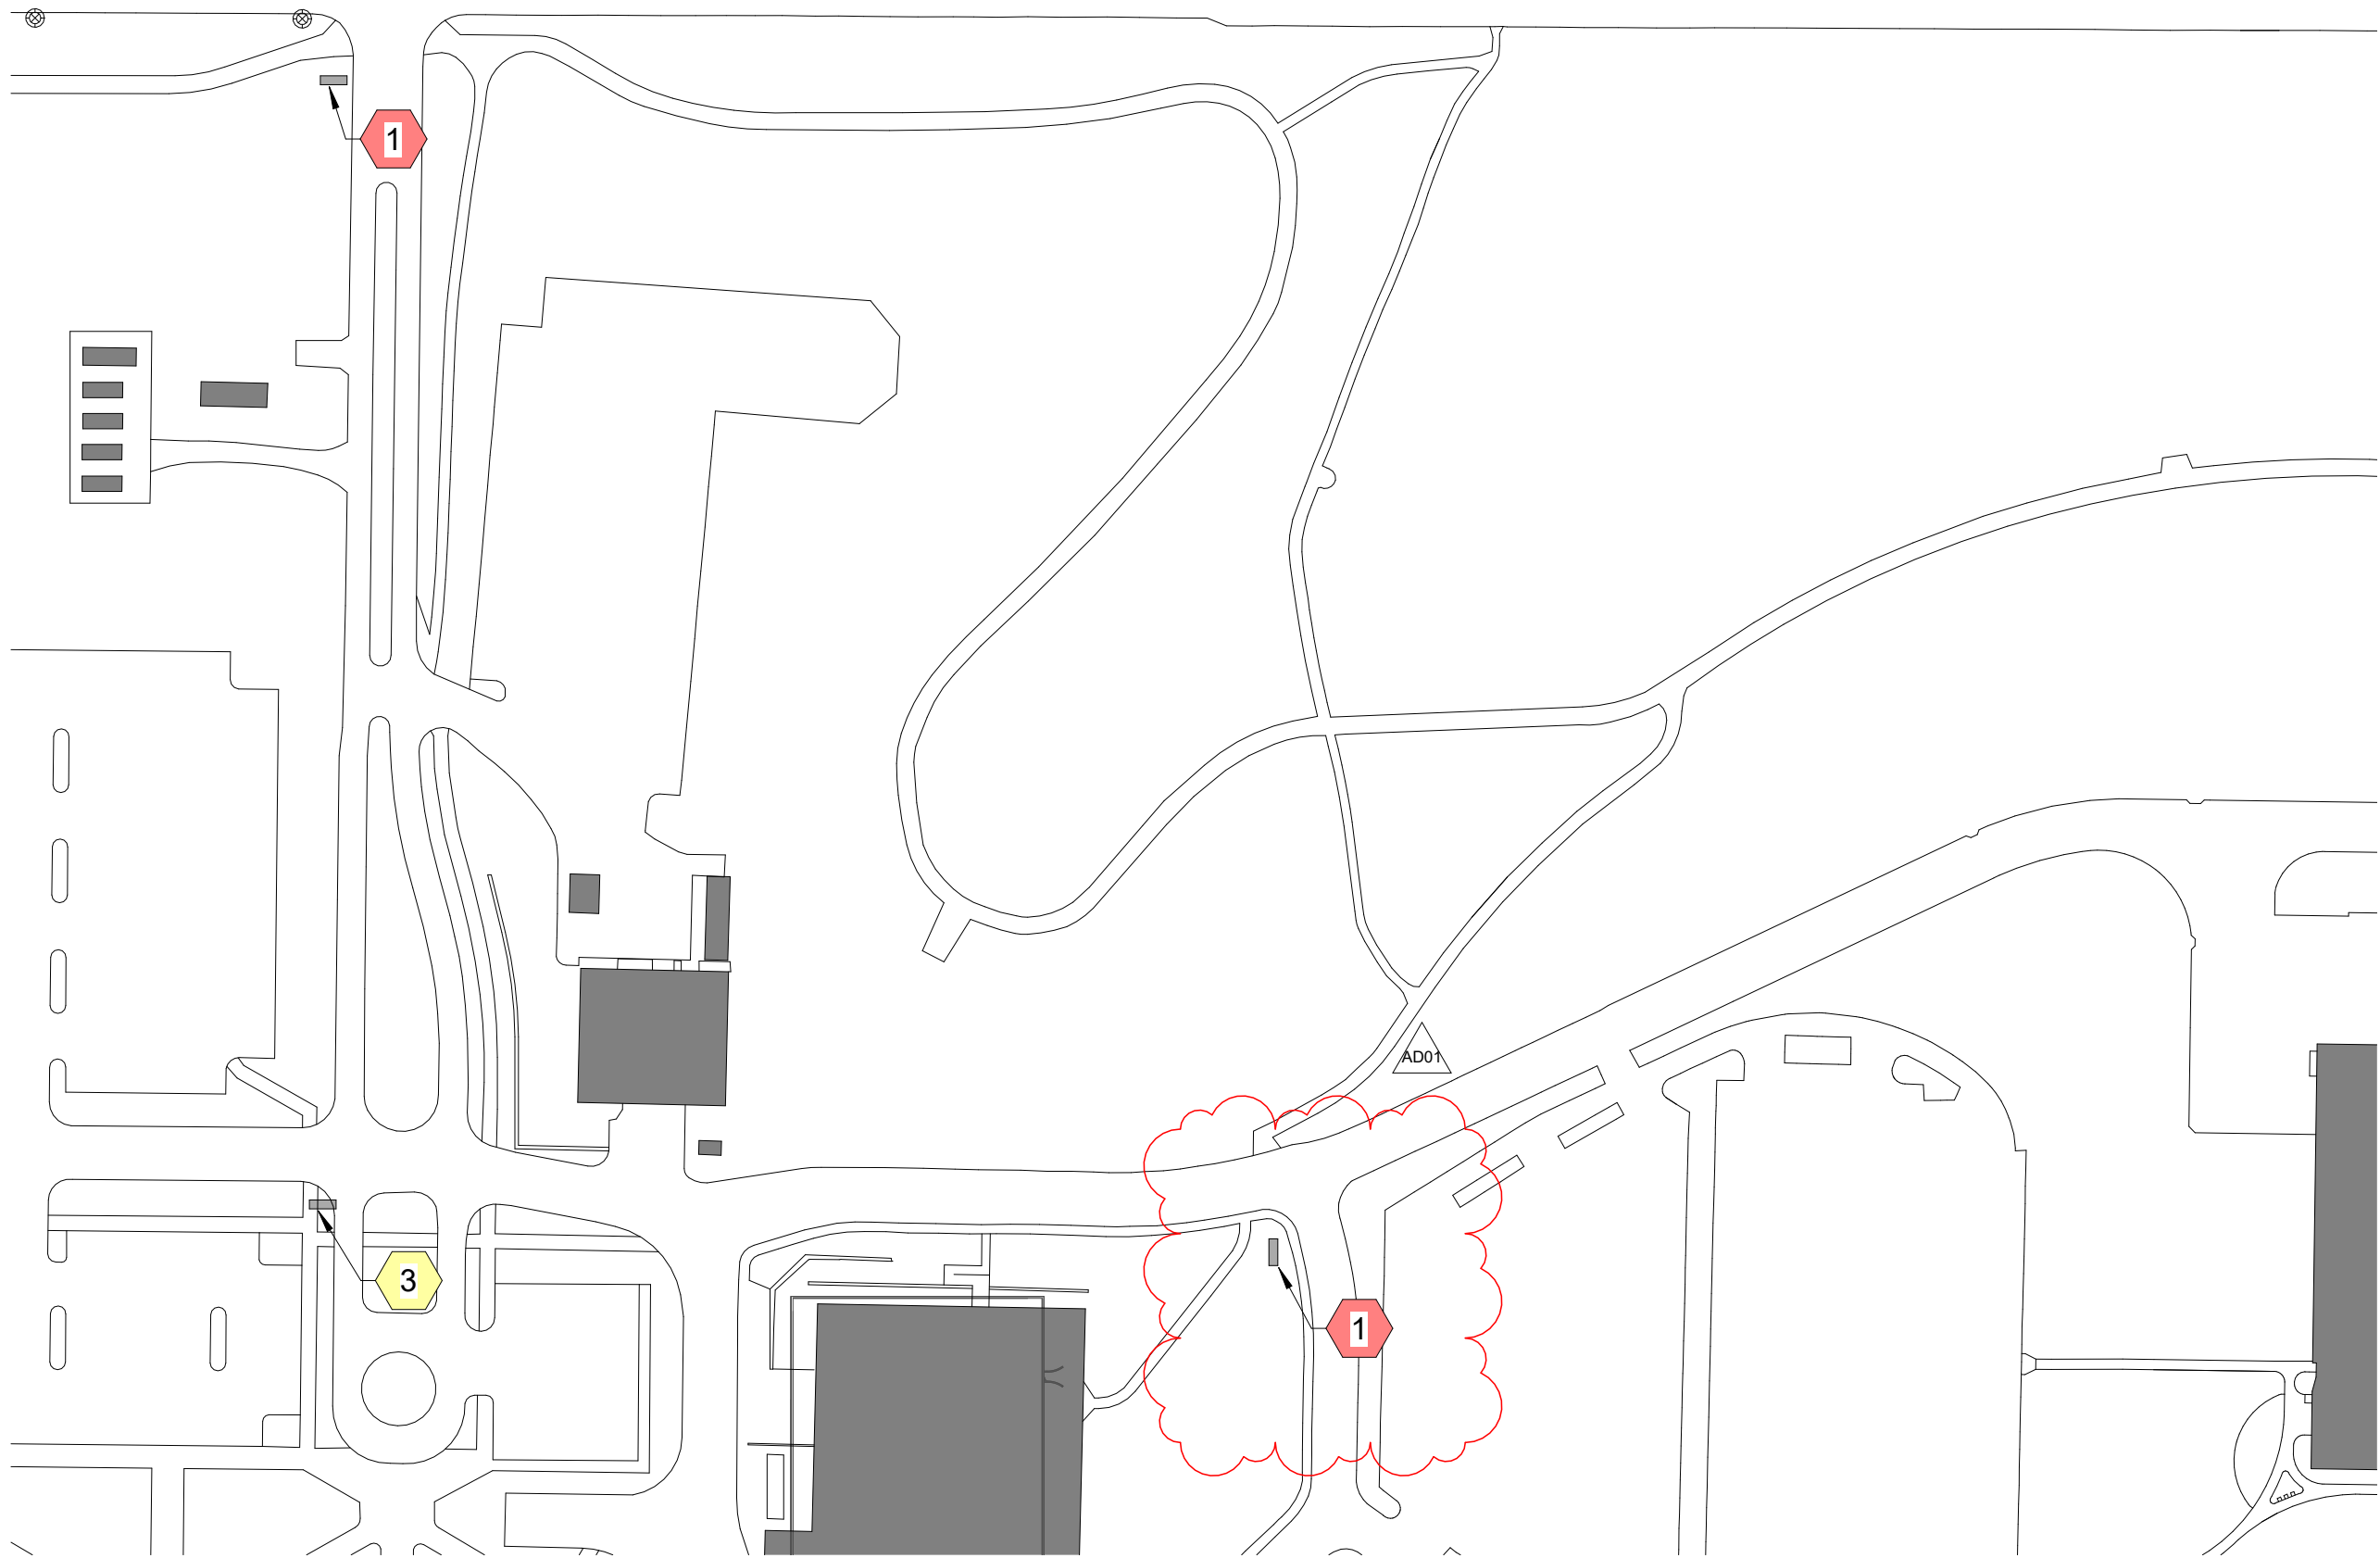

1 Site Plan - Area A
Scale: 1" = 100'-0"

September 8, 2026
J2 Project No. J22534

Addendum #
1

A1



architecture + design, pc


919 South 7th Street, Suite 400
Bismarck, ND 58504
(701) 255-1622

© 2026
All Rights Reserved

State of North Dakota
Capitol Visitor Enhancements - Exterior Signage
Bismarck, North Dakota

GENERAL PROJECT NSTALLATION NOTES:


CONTRACTOR SHALL INCLUDE 20' OF EXTRA TRENCHING/DIRECTIONAL BORING, CONDUIT AND CONDUCTORS **FOR EACH** SIGN LOCATION. SIGN LOCATIONS ARE APPROXIMATE AND LOCATIONS MAY BE FIELD ADJUSTED DUE TO VISIBILITY AND EXISTING UNDERGROUND UTILITY CONFLICTS.

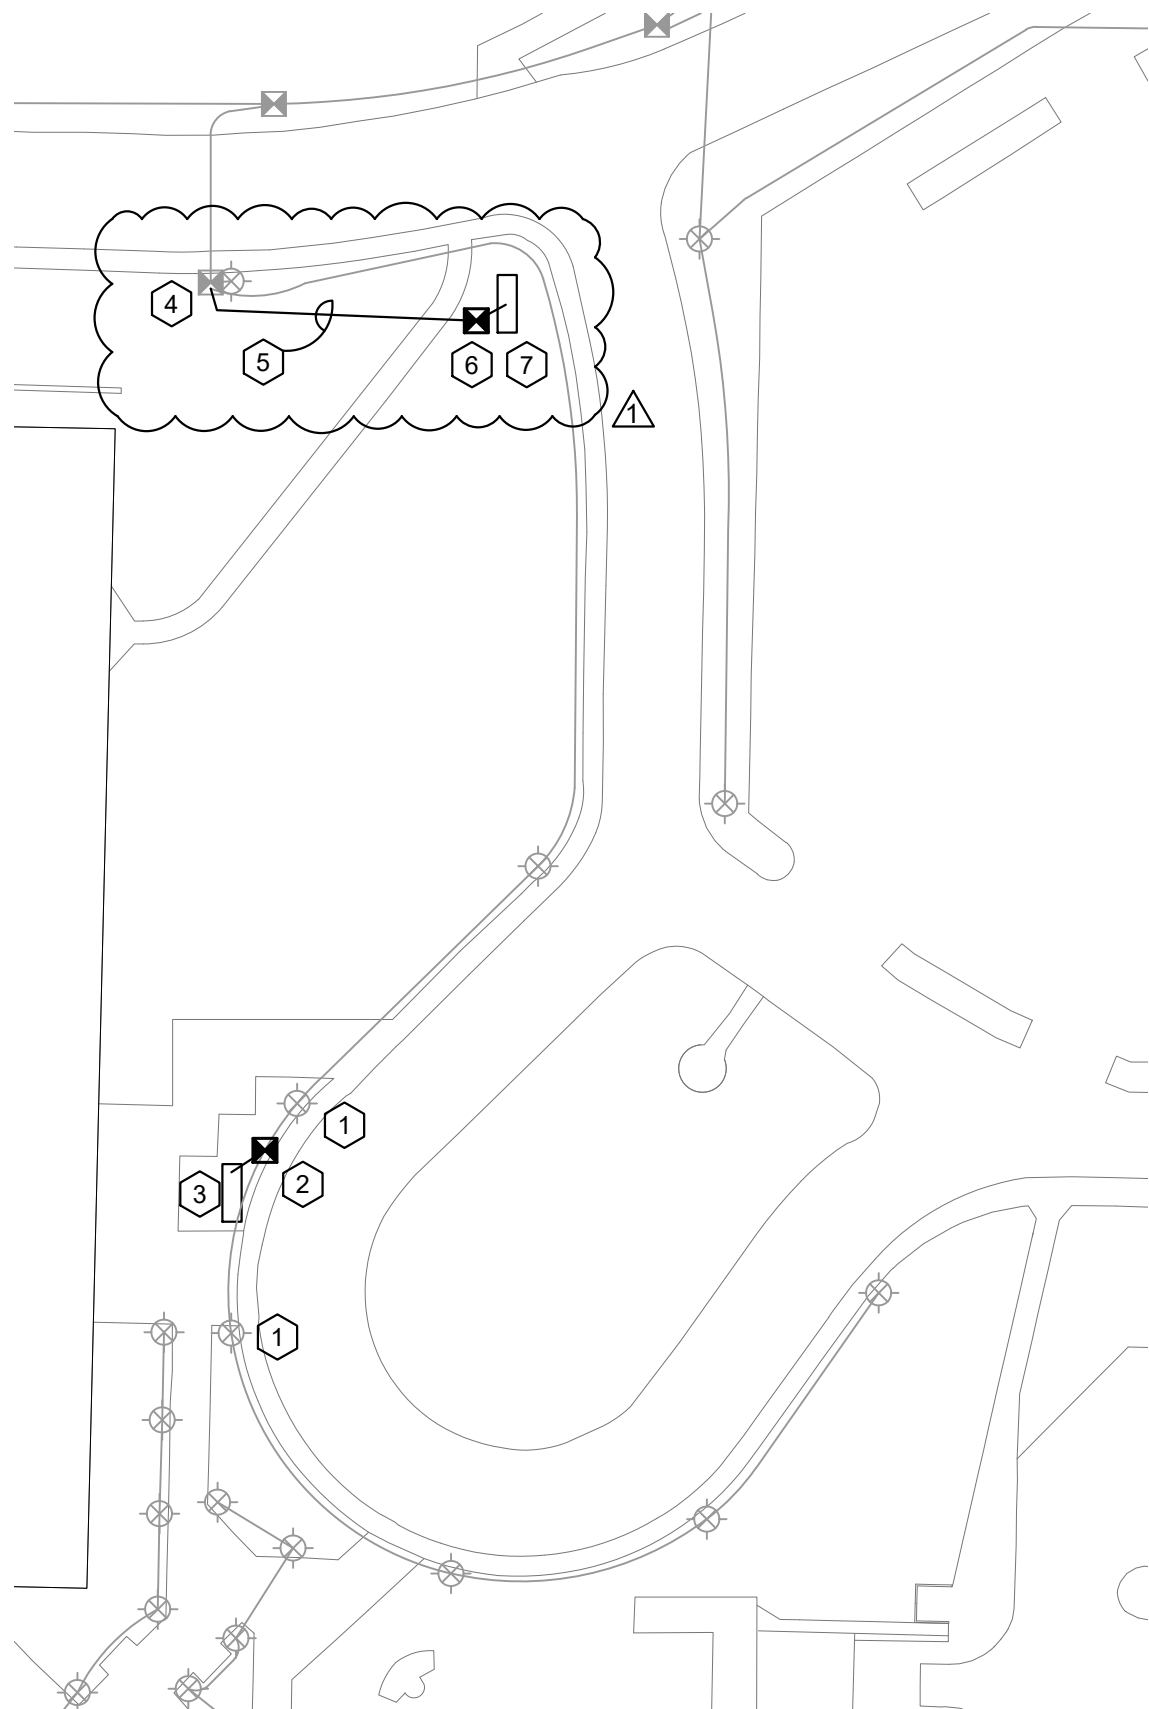

DETAIL 2/E102 ELECTRICAL INSTALLATION NOTES:

- EXISTING DIRECT EMBED CONCRETE POLE TYPE LIGHT FIXTURE TO REMAIN. EXISTING LIGHTING CIRCUIT APPEARS TO BE FED FROM FEED POINT LOCATED AT THE SOUTHEAST CORNER OF THE MAINTENANCE SHOP - VERIFY WITH FACILITY MANAGEMENT STAFF. AS REQUIRED, EXCAVATE DOWN ALONG POLE TO EXPOSE CONDUIT/CABLE ENTRY TO ALLOW CIRCUITRY MODIFICATIONS. REMOVE AND REPLACE CONCRETE PAD IF REQUIRED.
- PROVIDE NEW IN-GROUND BOX OVER EXISTING CIRCUITRY. EXISTING CIRCUITRY IS UNKNOWN IF IT IS ROUTED IN CONDUIT OR DIRECT BURIED.
 - IF IN CONDUIT: DISCONNECT CIRCUITRY IN NORTH LIGHT FIXTURE AND PULL BACK TO SOUTH FIXTURE LOCATION. MODIFY CONDUIT(SIZE TO MATCH EXISTING) TO BE ROUTED INTO NEW IN-GROUND BOX. PROVIDE NEW 2-#8+EGC CONDUCTORS BETWEEN BOTH EXISTING LIGHTS AND NEW IN-GROUND BOX.
 - IF DIRECT BURIED, DISCONNECT IN NORTH LIGHT FIXTURE AND EXPOSED ADEQUATE LENGTH OF EXISTING CONDUCTORS TO ALLOW RE-ROUTING OF CONDUCTORS FROM SOUTH FIXTURE INTO NEW IN-GROUND BOX. PROVIDE NEW 2-#8+EGC DIRECT BURIED CONDUCTORS FROM NEW IN-GROUND BOX TO NORTH LIGHT FIXTURE.
- PROPOSED PEDESTAL SIGN LOCATION. REFER TO SHEET E107, DETAIL 2 FOR INSTALLATION REQUIREMENTS. PROVIDE 3/4" CONDUIT WITH 2-#8+EGC CONDUCTORS BETWEEN NEW IN-GROUND BOX AND SIGN. DIRECT BURIED RATED CONNECTOR BLOCK EQUAL TO ILLSCO PED SERIES. PROVIDE LIGHTING OF ONE SIDE OF SIGN. CONTRACTOR TO VERIFY EXISTING SUPPLY VOLTAGE (277V) AND COORDINATE WITH LIGHTING FIXTURE SUPPLIER. CIRCUIT APPEARS TO BE FED FROM EXISTING FEEDPOINT LOCATED AT THE SOUTHEAST CORNER OF THE MAINTENANCE BUILDING.

2 AREA 2 ELECTRICAL PLAN - JUDICAL WING ENTRANCE
1" = 50'

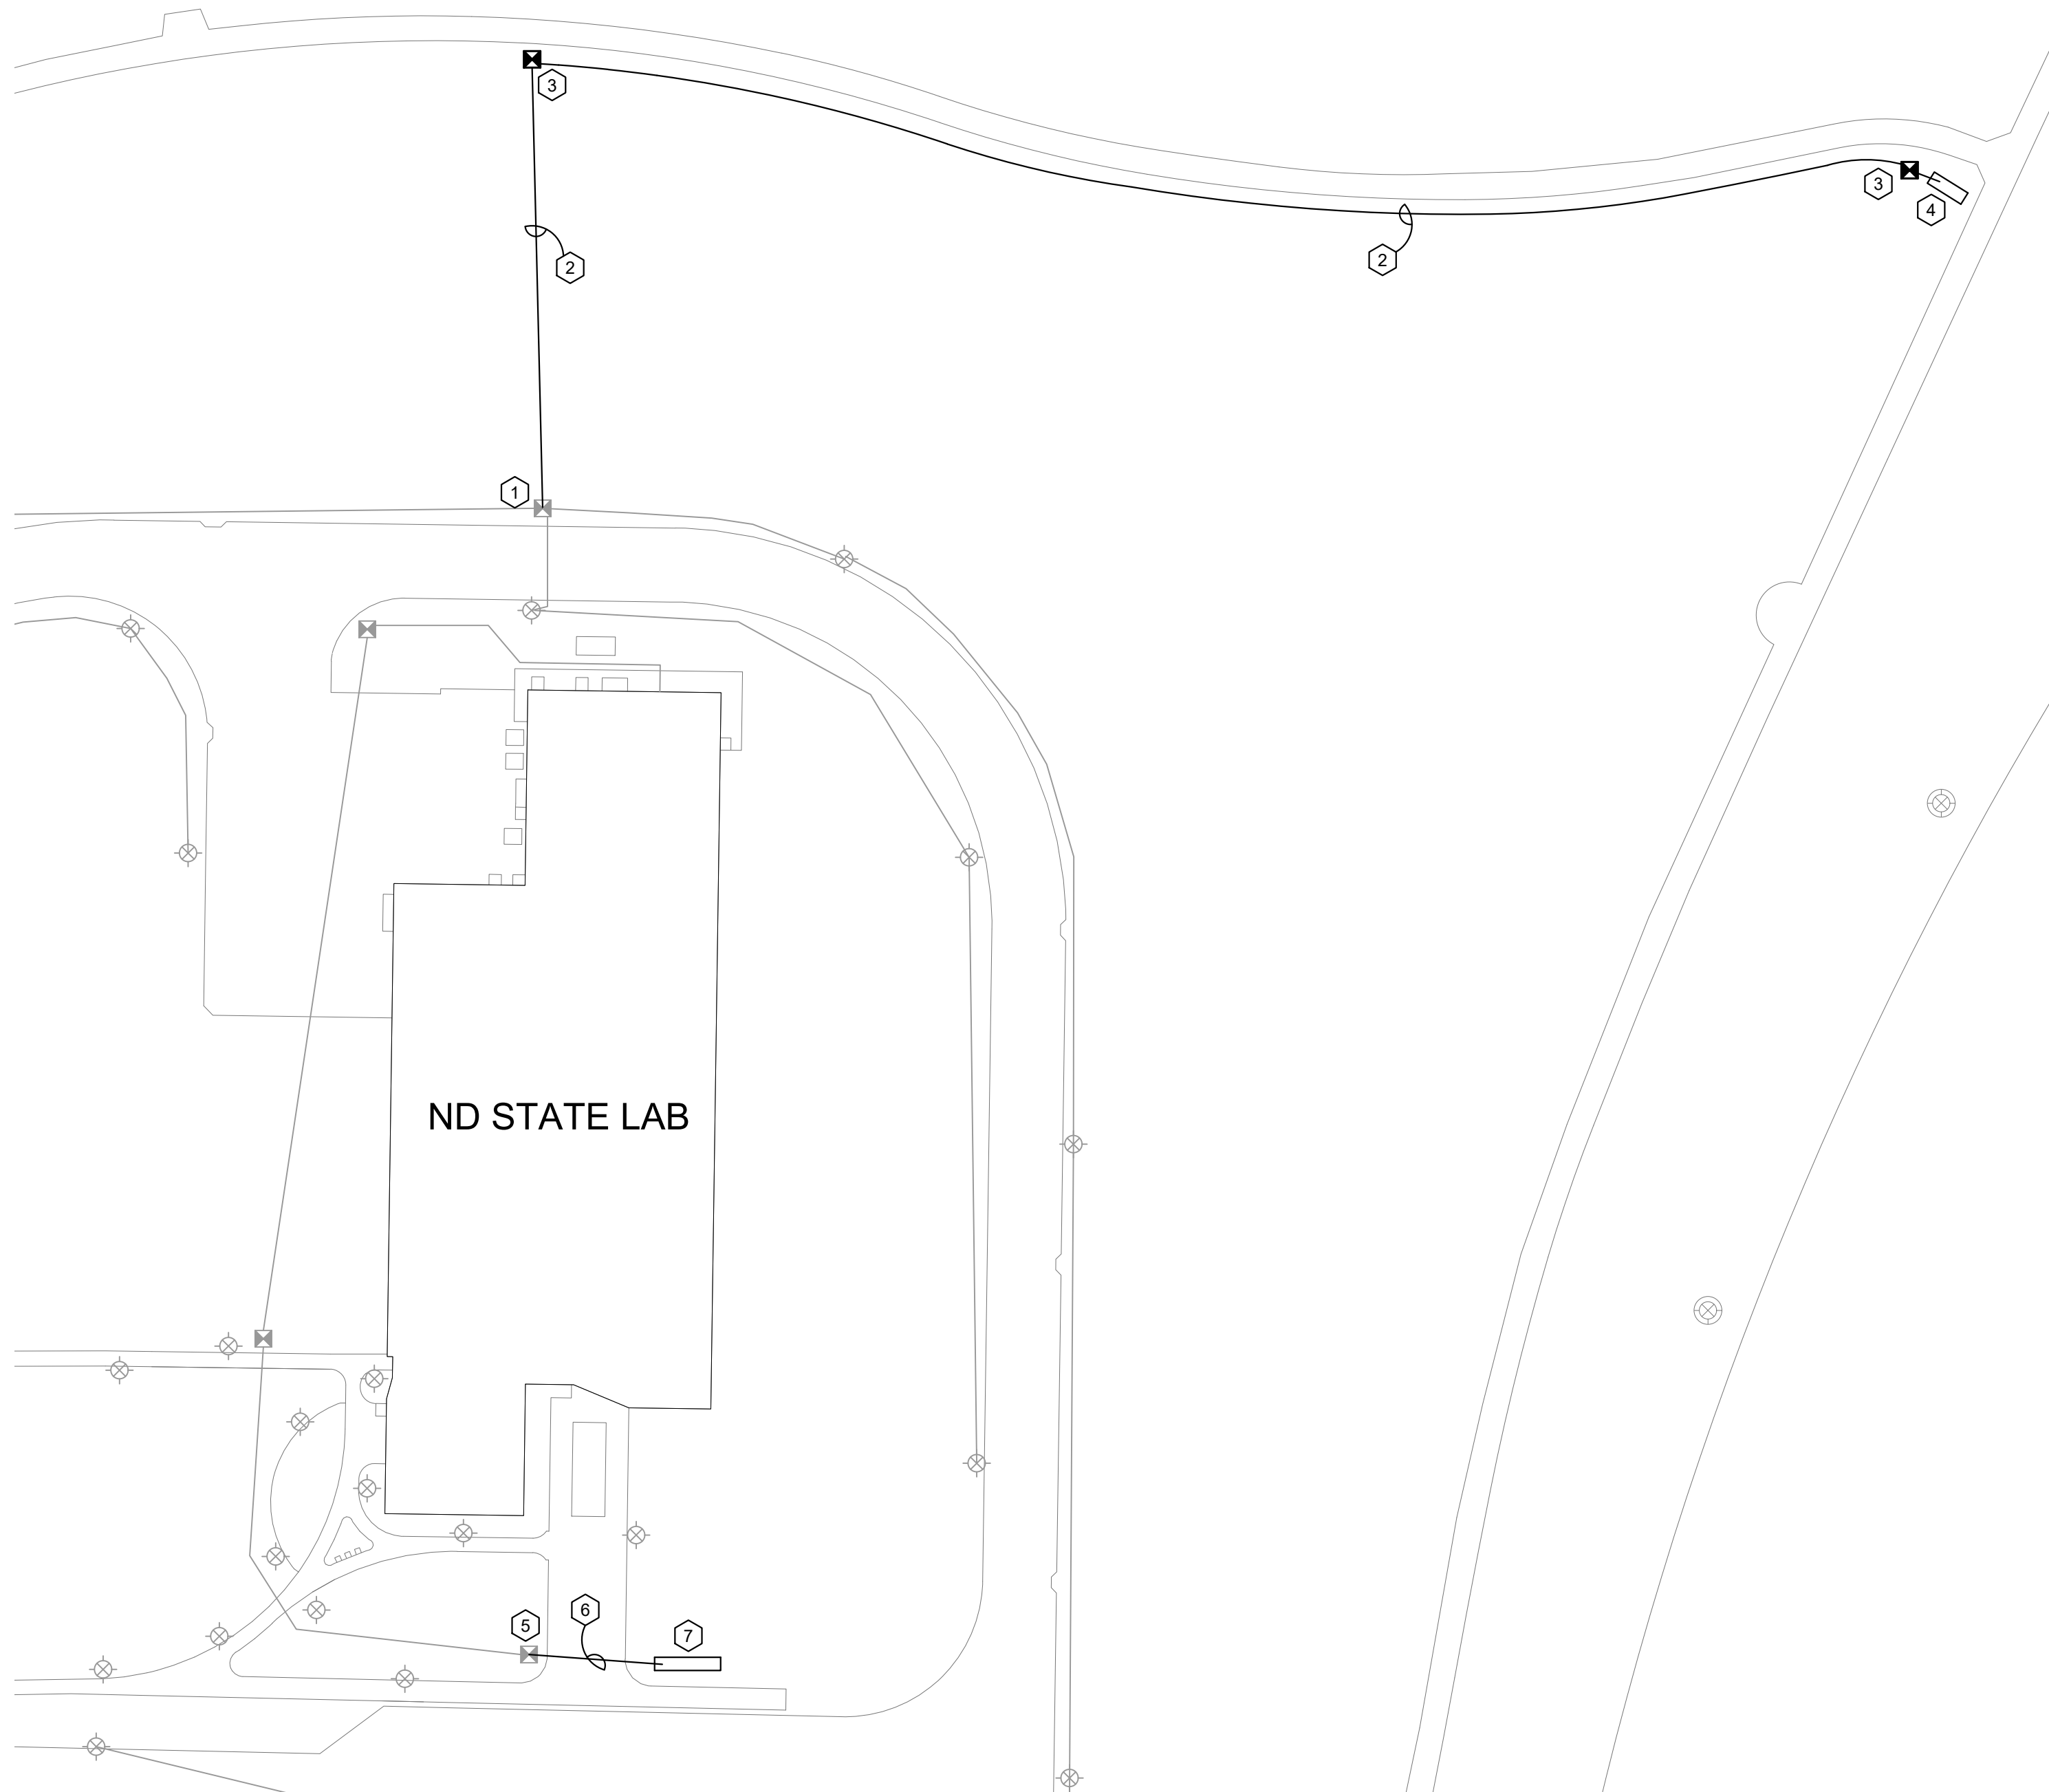

DETAIL 1/E102 ELECTRICAL INSTALLATION NOTES:

- APPROXIMATE LOCATION OF EXISTING IN-GROUND PULL BOX. REMOVE EXISTING 3-POSITION DIRECT BURIED RATED CONNECTOR BLOCKS AND PROVIDE A NEW 4-POSITION DIRECT BURIED RATED CONNECTOR BLOCK BY ILLSCO OR EQUAL. CONNECT NEW SIGN LIGHTING CIRCUIT TO EXISTING CIRCUITRY. EXISTING 277 VOLT LIGHTING CIRCUIT IS FED FROM THE EXISTING FEED POINT LOCATED AT THE SOUTHEAST CORNER OF THE MAINTENANCE SHOP.
- PROVIDE 1-1/4" SCH 40 PVC CONDUIT OR INNERDUCT WITH 2-#8+EGC CONDUCTORS. TRENCHING OF CIRCUITRY IS ACCEPTABLE.
- PROVIDE NEW IN-GROUND PULL BOX.
- PROPOSED PEDESTAL SIGN LOCATION. REFER TO SHEET E107, DETAIL 2 FOR INSTALLATION REQUIREMENTS. PROVIDE 3/4" CONDUIT WITH 2-#8+EGC CONDUCTORS BETWEEN NEW IN-GROUND BOX AND SIGN. PROVIDE LIGHTING OF ONE SIDE OF SIGN.

1 AREA 1 ELECTRICAL PLAN - NORTHWEST PEDESTRIAN PATH
1" = 50'

- ALTERNATE BID #E3:** EXISTING IN-GROUND BOX WITH EXISTING 277V CIRCUIT FED FROM PANEL H11 IN MAIN ELECTRICAL ROOM ON NORTH END OF THE STATE LAB BUILDING. CONNECT NEW SIGN LIGHTING CIRCUIT TO EXISTING SPARE CONDUCTORS.
- ALTERNATE BID #E3:** DIRECTIONAL BORE A 3/4" CONDUIT WITH 2-#8+EGC CONDUCTORS BETWEEN EXISTING IN-GROUND BOX AND NEW MONUMENT SIGN.
- ALTERNATE BID #E3:** PROPOSED MONUMENT SIGN LOCATION. REFER TO SHEET E107, DETAIL 1 FOR INSTALLATION REQUIREMENTS. PROVIDE SINGLE POINT CONNECTION TO INTERNALLY ILLUMINATED SIGNAGE. CONTRACTOR TO VERIFY EXISTING SUPPLY VOLTAGE (277 VOLT) AND COORDINATE WITH LIGHTING FIXTURE SUPPLIER.

REVISIONS		
MARK	DATE	DESCRIPTION
△	09/08/26	ADDENDUM #1

Contract Documents

August 27, 2026
J2 Project No. J22534

State of North Dakota
Capitol Visitor Enhancements -
Exterior Signage
Bismarck, North Dakota



919 South 7th Street, Suite 400
Bismarck, ND 58504
(701) 255-1622

© 2026 All Rights Reserved


AREA 1 & 2
ELECTRICAL
PLAN

E102



GENERAL PROJECT NSTALLATION NOTES:


CONTRACTOR SHALL INCLUDE 20' OF EXTRA TRENCHING/DIRECTIONAL BORING, CONDUIT AND CONDUCTORS **FOR EACH** SIGN LOCATION. SIGN LOCATIONS ARE APPROXIMATE AND LOCATIONS MAY BE FIELD ADJUSTED DUE TO VISIBILITY AND EXISTING UNDERGROUND UTILITY CONFLICTS.

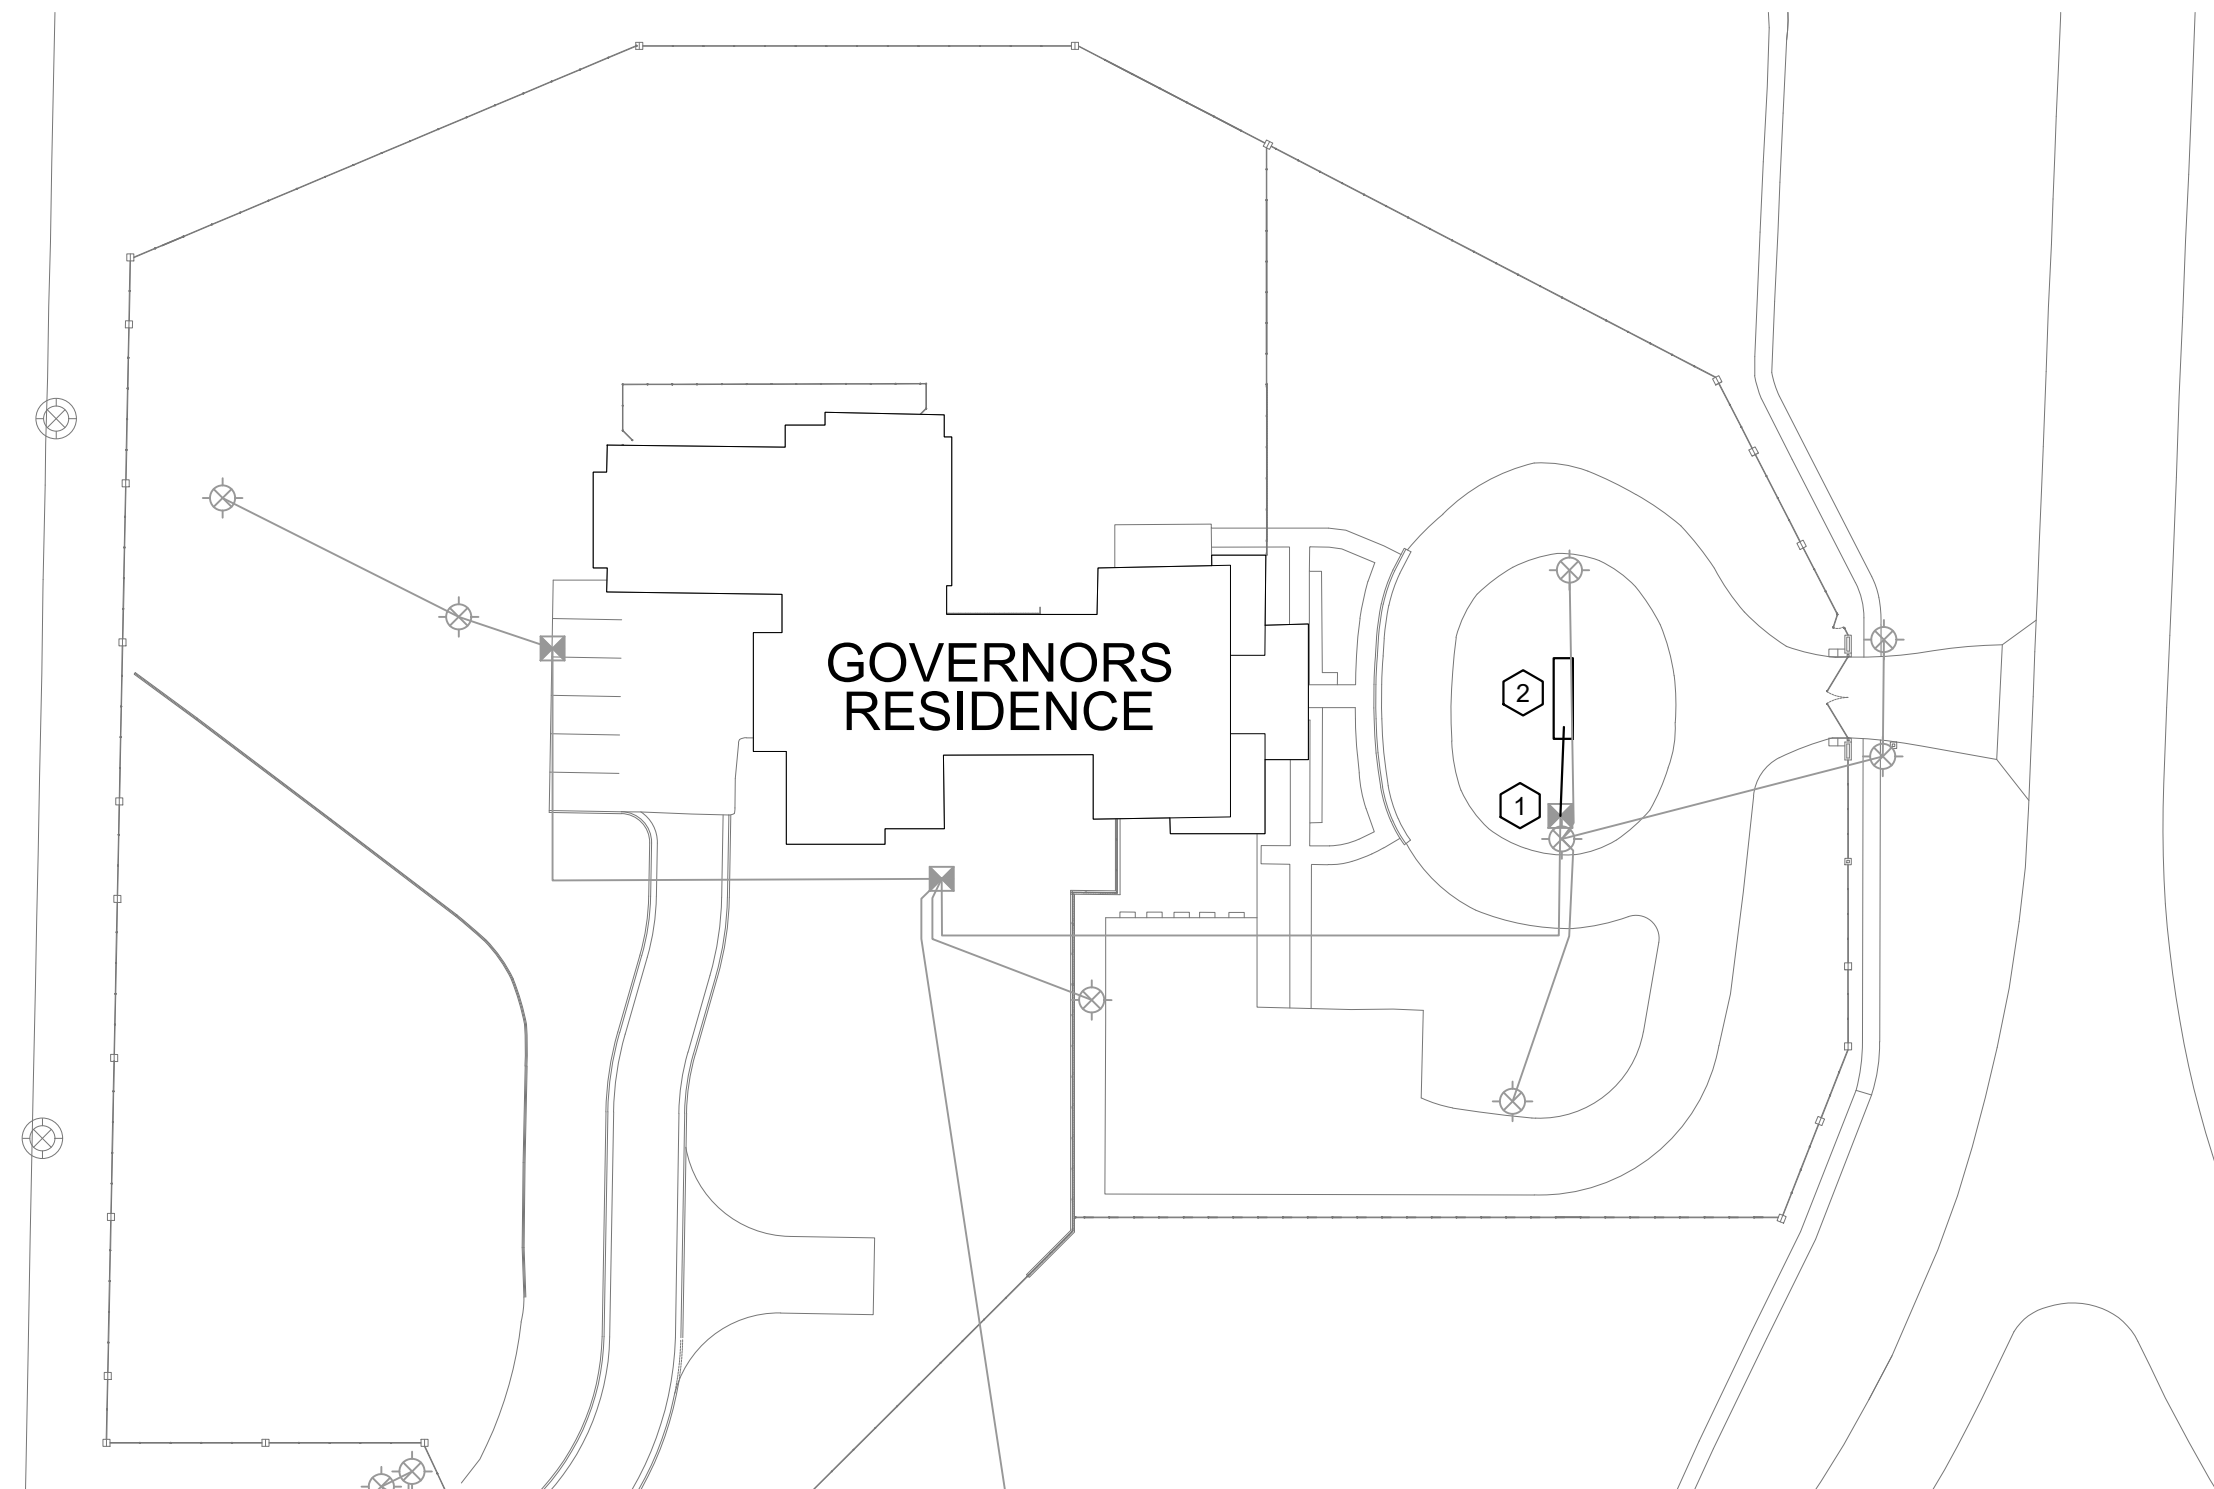

DETAIL 2/E104 ELECTRICAL INSTALLATION NOTES:

- 1 **ALTERNATE BID #E4** EXISTING IN-GROUND BOX WITH EXISTING LIGHTING CIRCUIT FED FROM GOVERNOR'S RESIDENCE. REMOVE EXISTING DIRECT BURIED CONNECTOR BLOCK AND PROVIDE A NEW 6-POSITION(VERIFY) DIRECT BURIED CONNECTOR BLOCK EQUAL TO ILLSCO PED SERIES TO CONNECT SIGN LIGHTING CIRCUITRY TO EXISTING LIGHTING CIRCUITRY.
- 2 **ALTERNATE BID #E4** PROPOSED MONUMENT SIGN LOCATION. REFER TO SHEET E107, DETAIL 1 FOR INSTALLATION REQUIREMENTS. PROVIDE 3/4" CONDUIT WITH 2-#8+EGC CONDUCTORS BETWEEN EXISTING IN-GROUND BOX AND SIGN. PROVIDE SINGLE POINT CONNECTION TO INTERNALLY ILLUMINATED SIGNAGE. CONTRACTOR TO VERIFY EXISTING SUPPLY VOLTAGE (120 VOLT) AND COORDINATE WITH LIGHTING FIXTURE SUPPLIER.

2 AREA 5 ELECTRICAL PLAN - GOVERNOR'S RESIDENCE
1" = 50'

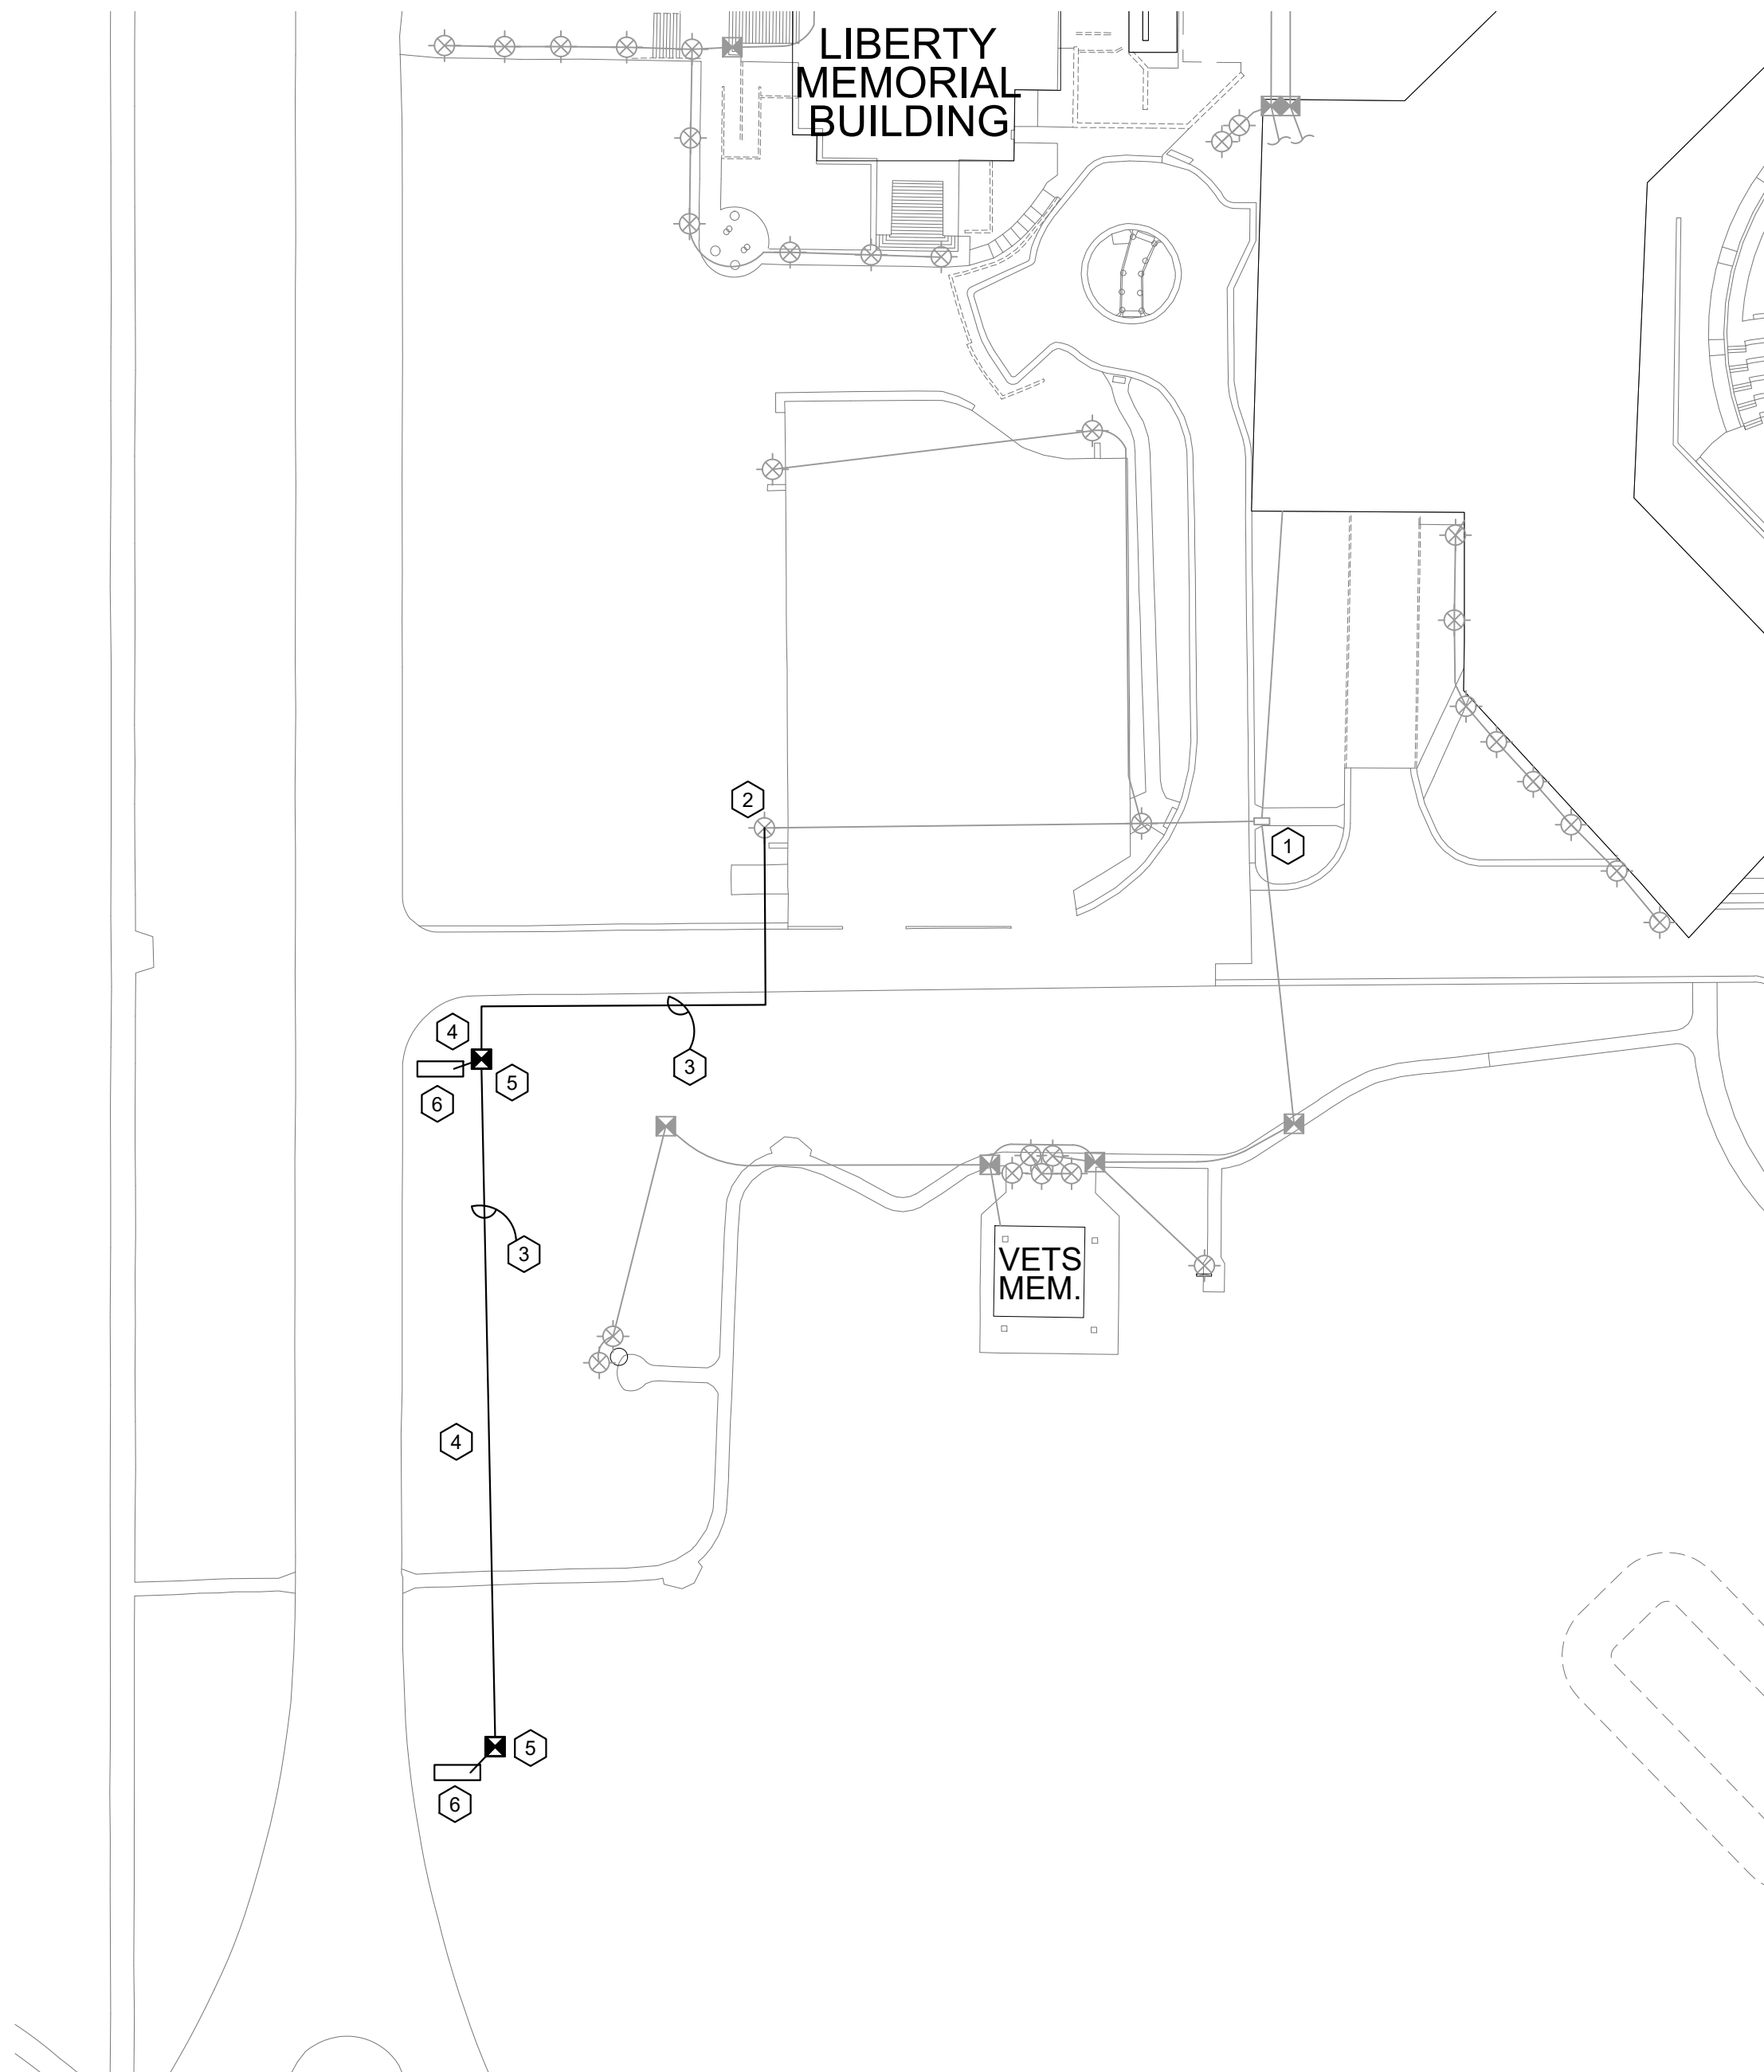

DETAIL 1/E104 ELECTRICAL INSTALLATION NOTES:

- 1 EXISTING FEED POINT FOR SITE LIGHTING IN THIS GENERAL AREA. EXISTING PARKING LOT LIGHTING IS FED FROM AN EXISTING 30-AMP SINGLE POLE, 120 VOLT BREAKER.
- 2 EXISTING DIRECT EMBED POLE TYPE AREA LIGHT FIXTURE TO REMAIN. EXCAVATE DOWN ALONG POLE TO EXPOSE CONDUIT/CABLE ENTRY TO ALLOW CIRCUITRY ADDITIONS. CONNECT NEW SIGN LIGHTING CIRCUITRY TO EXISTING PARKING LOT LIGHTING CIRCUIT WITHIN POLE. REMOVE AND REPLACE EXISTING CONCRETE PAD AROUND POLE IF REQUIRED.
- 3 PROVIDE 1-1/4" WITH 2-#8+EGC CONDUCTORS INSTALLED UTILIZING DIRECTIONAL BORING TO MINIMIZE DISRUPTION TO EXISTING SURFACES.
- 4 FIELD VERIFY ROUTING OF NEW CIRCUITRY AND IN-GROUND BOX LOCATION WITH EXISTING UNDERGROUND TELECOMMUNICATIONS UTILITIES IN THESE AREAS. ADJUST ROUTING IN THE FIELD AS COORDINATED WITH THE ENGINEER.
- 5 PROVIDE NEW IN-GROUND BOX AT NEW SIGN LOCATION. PROVIDE DIRECT BURIED CONNECTOR BLOCKS EQUAL TO ILLSCO PED SERIES. FIELD VERIFY INSTALLATION LOCATION.
- 6 PROPOSED PEDESTAL SIGN LOCATION. REFER TO SHEET E107, DETAIL 2 FOR INSTALLATION REQUIREMENTS. PROVIDE 3/4" CONDUIT WITH 2-#8+EGC CONDUCTORS BETWEEN NEW IN-GROUND BOX AND SIGN. PROVIDE LIGHTING OF **BOTH SIDES** OF SIGN. CONTRACTOR TO VERIFY EXISTING SUPPLY VOLTAGE AND COORDINATE WITH LIGHTING FIXTURE SUPPLIER.

1 AREA 4 ELECTRICAL PLAN - LIBERTY MEMORIAL BUILDING AREA
1" = 50'

REVISIONS		
MARK	DATE	DESCRIPTION
△	09/08/26	ADDENDUM #1

Contract Documents

August 27, 2026
J2 Project No. J22534

State of North Dakota
Capitol Visitor Enhancements -
Exterior Signage
Bismarck, North Dakota



919 South 7th Street, Suite 400
Bismarck, ND 58504
(701) 255-1622

© 2026 All Rights Reserved

AREA 4 & 5
ELECTRICAL
PLAN

E104

Planholders List - #J22534

State of North Dakota

Capitol Visitor's Enhancements - Exterior Signage

Bismarck, ND



Set	Planholder	Mailing Address	City	State	Zip	Phone #	Fax #	Contact Name	Email Address
1	State of North Dakota	600 East Boulevard Avenue	Bismarck	ND	58505	701-328-4738	-	Tom Job	tjob@nd.gov
E	J2 Studio Architecture + Design	919 S. 7th Street, Suite 400	Bismarck	ND	58504	701-255-1622	701-223-8927	James Devine/Carrie Meyer	james@j2studio.us
E	CWStructural	1000 Calgary Avenue, Suite 2	Bismarck	ND	58503	701-221-3286	-	Chris Wentz	chriswentz@cwstructural.com
E	Apex Engineering	600 South Second Street, Suite 145	Bismarck	ND	58504	701-323-3950	-	Wes Gullicks	wes.gullicks@apexenggroup.com
E	Capital City Construction	1501 E Calgary Avenue	Bismarck	ND	58503	701- 255-4002	701- 222-0731	Heather Miller	heather@cccincnd.com
E	Northwest Contracting	2840 Valley Forge Street	Bismarck	ND	58503	701-255-7727	701-255-2825	Brooks Sabot	brooks@northwestcontracting.com
E	Roers Construction	1260 West Villard	Dickinson	ND	58602	701- 483-1686	-	Matt Thomas	mthomas@roers.com
E	Braun Electric	1620 4th Avenue NW	Minot	ND	58703	701-837-4750	-	Matthew Wald	matthew@braun-electric.com
E	Edling Electric	P.O. Box 1451	Bismarck	ND	58502	701-255-2831	701-255-2835	Jason Rodd	jasonrodd@edlingelectric.com
E	Fetzer Electric	2501 Angus Drive	Bismarck	ND	58504	701-751-3389	701-751-3390	Farrell Fetzer	farrell@fetzerelectricllc.com
E	Magnum Electric	820 S. 18th Street	Bismarck	ND	58504	701-751-3033	-	Dave Rost/Josh Morisch	dave@magnumelectric.net
E	Skeels Electric Co.	PO Box 5009	Bismarck	ND	58502	701-223-5440	701-255-1797	Thomas Wolf	thomas@skeelselectric.com
E	Bismarck-Mandan Builders Exchange	805 Adobe Trail SE	Mandan	ND	58554	701-667-4322	701-667-5217	Julie Monzelowsky	bismanbldrex@gmail.com
E	Bismarck Builders Exchange	215 Airport Rd	Bismarck	ND	58504	701-258-4215	701-258-1391	Sandy Kerzman	info@bbxnd.com
E	Fargo-Moorhead Builders Exchange	1010 Page Dr	Fargo	ND	58103	701-237-6772	701-232-1653	Calisa Nickelson	info@fmbx.org
E	Minnesota Builders Exchange	1123 Glenwood Avenue	Minneapolis	MN	58405	612-381-2620	701- 381-2621	Jeff Boelter	jeffb@mbex.org
E	Builders Exchange of Billings	2050 Broadwater Ave, Suite A	Billings	MT	59102	406-652-1311	406-652-1391	Luke Hudson	bbx@billingsplanroom.com
E	Bozeman Planroom	1105 Reeves Rd W, Suite 800	Bozeman	MT	59718	406-586-7653	406-586-4062	Stan Wagner	exchange@bozemanplanroom.com
E	Missoula Builders Exchange	201 N Russell St	Missoula	MT	59801	406-549-5502	406-721-2941	Twyla Brooks	tbrooks@mpe.us
E	Construction Industry Center	2771 Plant St	Rapid City	SD	57702	605-343-5252	605-343-4591	Kasi Kuiper	kasi@constructionindustrycenter.com
E	Construct Connect	3825 Edwards Road, Suite 800	Cincinnati	OH	45209	513-458-8578	-	Pam Brown	pamela.brown@constructconnect.com
E	Dodge Construction Network	2860 S. State Highway 161, Suite 160 #151	Grand Prairie	TX	75052	844-326-3826 ext. 2943	-	Brandi Flanagan	brandi.flanagan@construction.com

Printed Copies = \$2.10/sheet for drawings and \$.12/page for specifications

Pre-Bid Meeting: 09.01.2026
J22534 State of North Dakota Capitol Visitor Enhancements - Exterior Signage

Pre-Bid Meeting: 09.01.2026
J22534 State of North Dakota Capitol Visitor Enhancements - Exterior Signage

[illegible]